


B BASEMENT FLOOR PLAN
SCALE: 3/32" = 1'-0"

DEPARTMENT INDEX: BASEMENT	
OESC	7,995 sqft.
OMES	2,695 sqft.
AGRICULTURE	2,115 sqft.
STATE ELECTION BOARD	3,270 sqft.
GOODWILL	100 sqft
BUILDING SUPPORT	8,100 sqft
	<hr/> 24,275 sqft

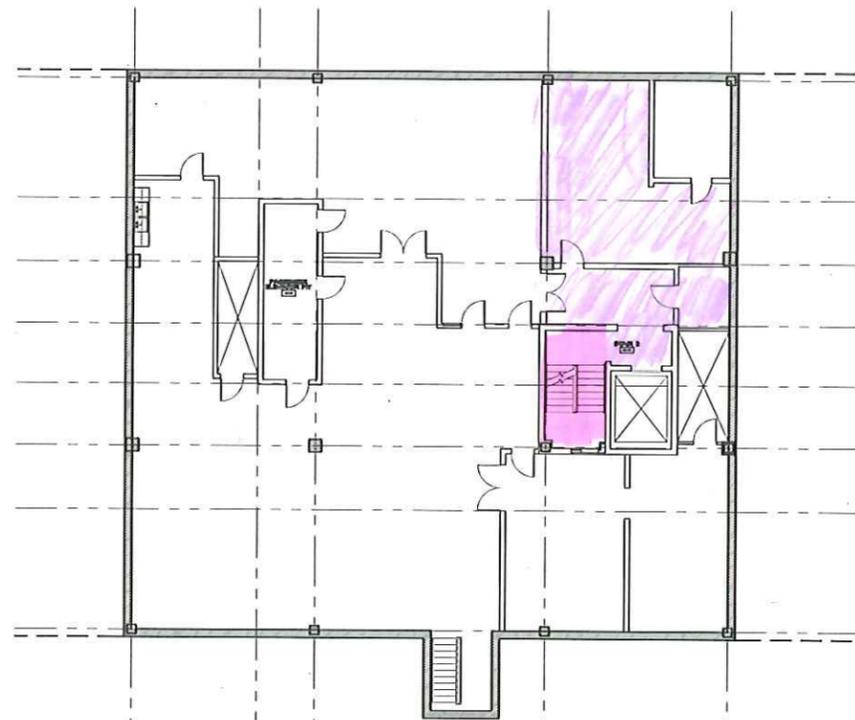

A SUBBASEMENT FLOOR PLAN
SCALE: 3/32" = 1'-0"

- CONCRETE —
- MARBLE —
- VCT TILE —
- CARPET — Gray area not colored in.
- RUBBER —
- 2"x2" CERAMIC TILE —

DEPARTMENT INDEX: SUB-BASEMENT FLOOR	
BUILDING SUPPORT	6,050 sqft
	<hr/> 6,050 sqft

Will Rogers
Existing Conditions
Oklahoma City, Oklahoma
Floor Plans

GH2 ARCHITECTS
320 South Boston, Suite 1600
Tulsa, OK 74103
T: 918.587.6158 GH2.COM
A SPECIALTY PRACTICE OF GH2 ARCHITECTS, LLC

INTERIM REVIEW ONLY
DOCUMENT INCOMPLETE.
NOT INTENDED FOR PERMIT,
BIDDING OR CONSTRUCTION

ARCHITECT: THOMAS C. SEAT
LICENSE #: 4193

PROJECT #: 20120027.43

ISSUE DATES:
05/12/14 As-built Review


SHEET NUMBER:
A101

© 2015 COPYRIGHT GH2 ARCHITECTS, LLC

DECOR CONCRETE — *|||||*
 VCT TILE — *|||||*
 CARPET — *|||||*
 RUBBER — *|||||*
 2"x2" CERAMIC TILE — *|||||*
 MARBLE — *|||||*

DEPARTMENT INDEX:
1ST FLOOR

	OMES	17,622 sqft
	CONFERENCE ROOM	870 sqft
	BUILDING SUPPORT	4,593 sqft
		<hr/> 23,085 sqft

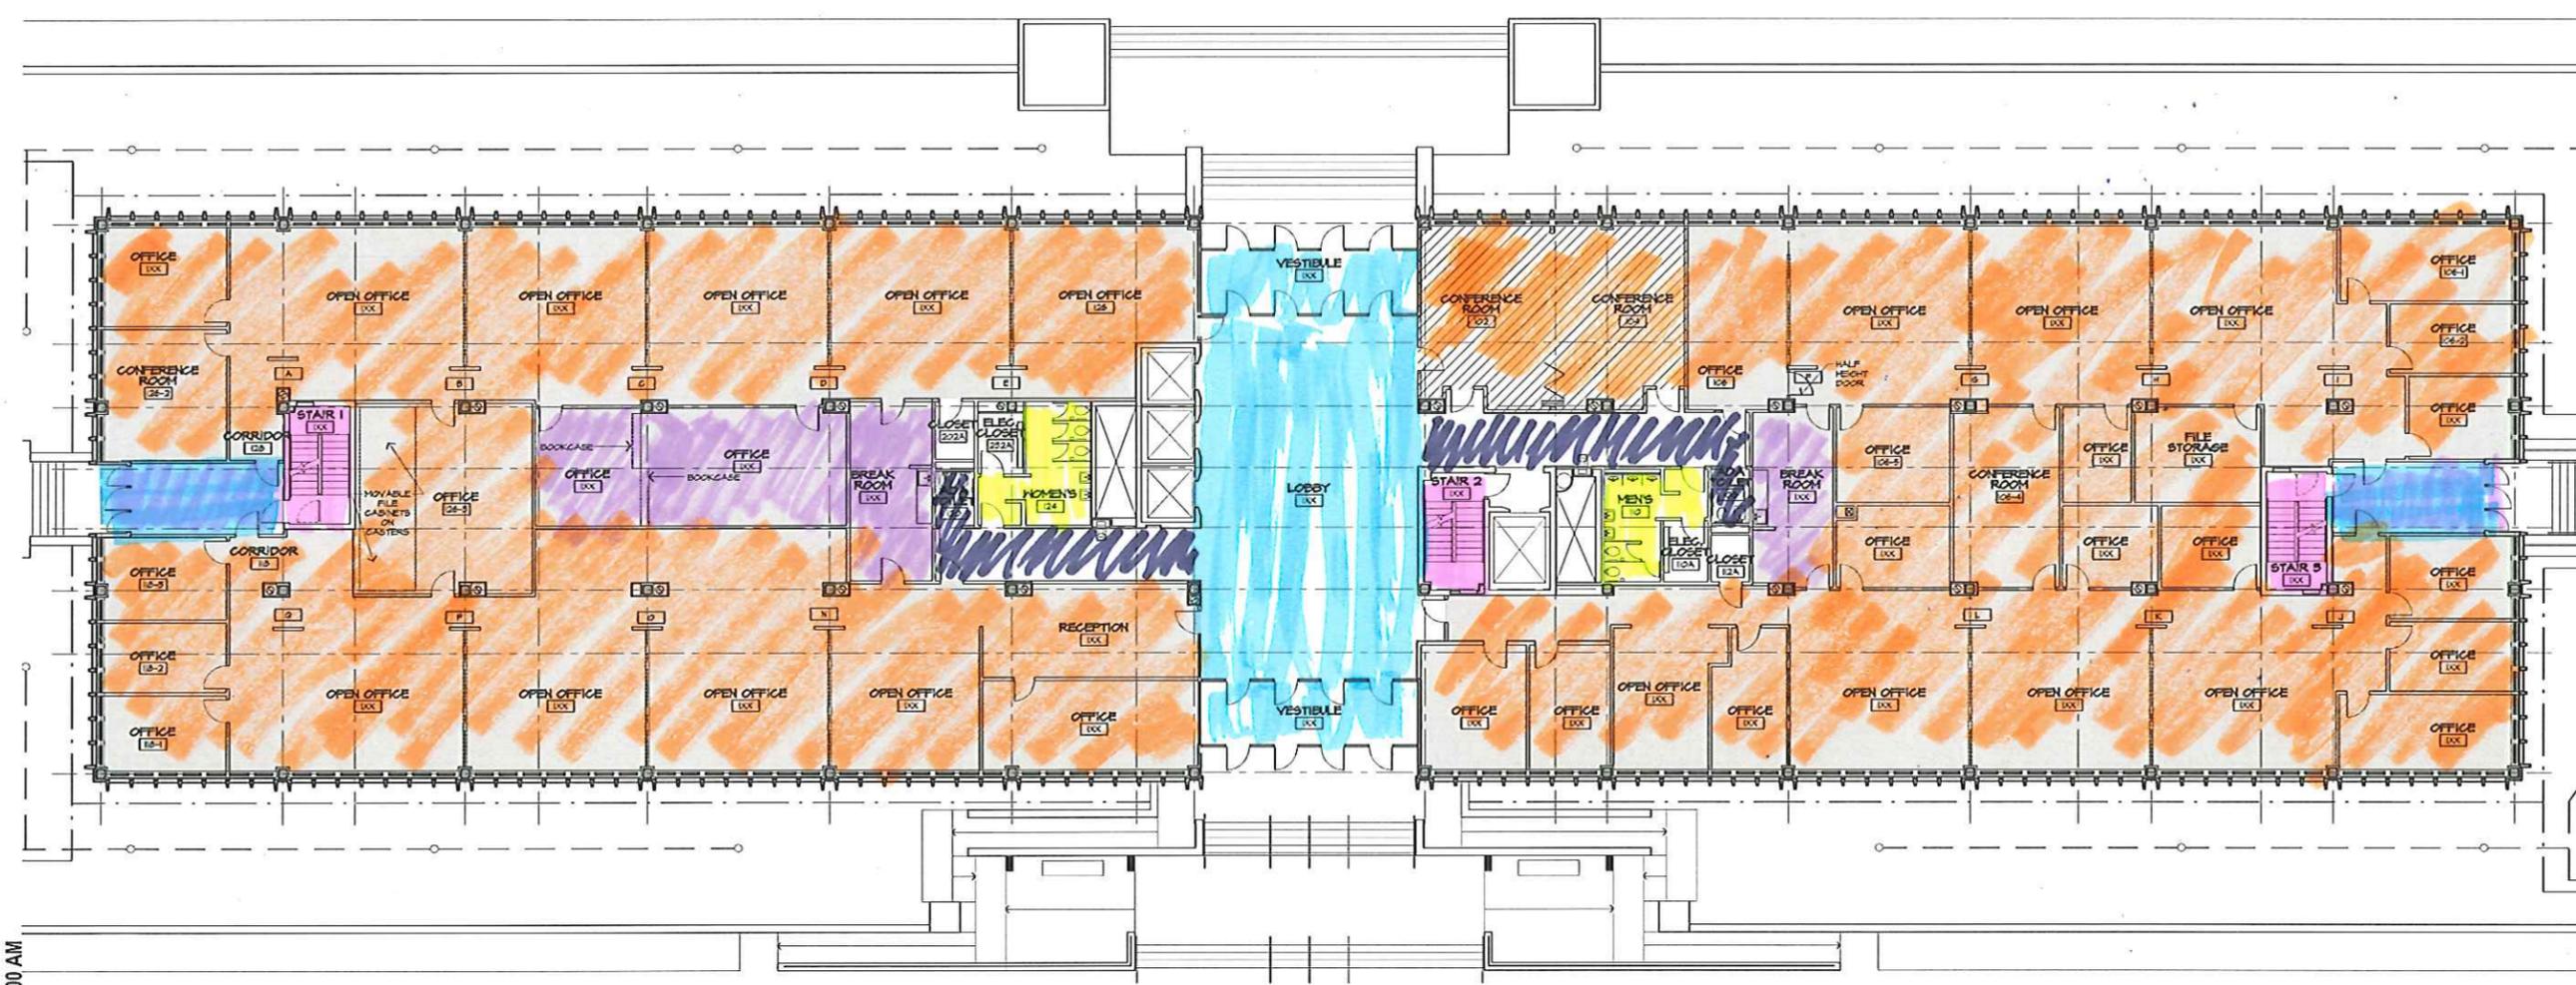

Will Rogers
Existing Conditions
 Oklahoma City, Oklahoma
 Floor Plans

GH2 ARCHITECTS
 320 South Boston, Suite 1600
 Tulsa, OK 74103
 T: 918.587.6158 GH2.COM
 A SPECIALTY PRACTICE OF GH2 ARCHITECTS, LLC


INTERIM REVIEW ONLY
 DOCUMENT INCOMPLETE.
 NOT INTENDED FOR PERMIT,
 BIDDING OR CONSTRUCTION
 ARCHITECT: THOMAS C. SEAT
 LICENSE #: 4153

PROJECT #: 20120027.43
 ISSUE DATES:
 05/12/14 As-built Review

SHEET NUMBER:
A102
 © 2015 COPYRIGHT GH2 ARCHITECTS, LLC

PRINTED: 5/12/2015 10:00 AM



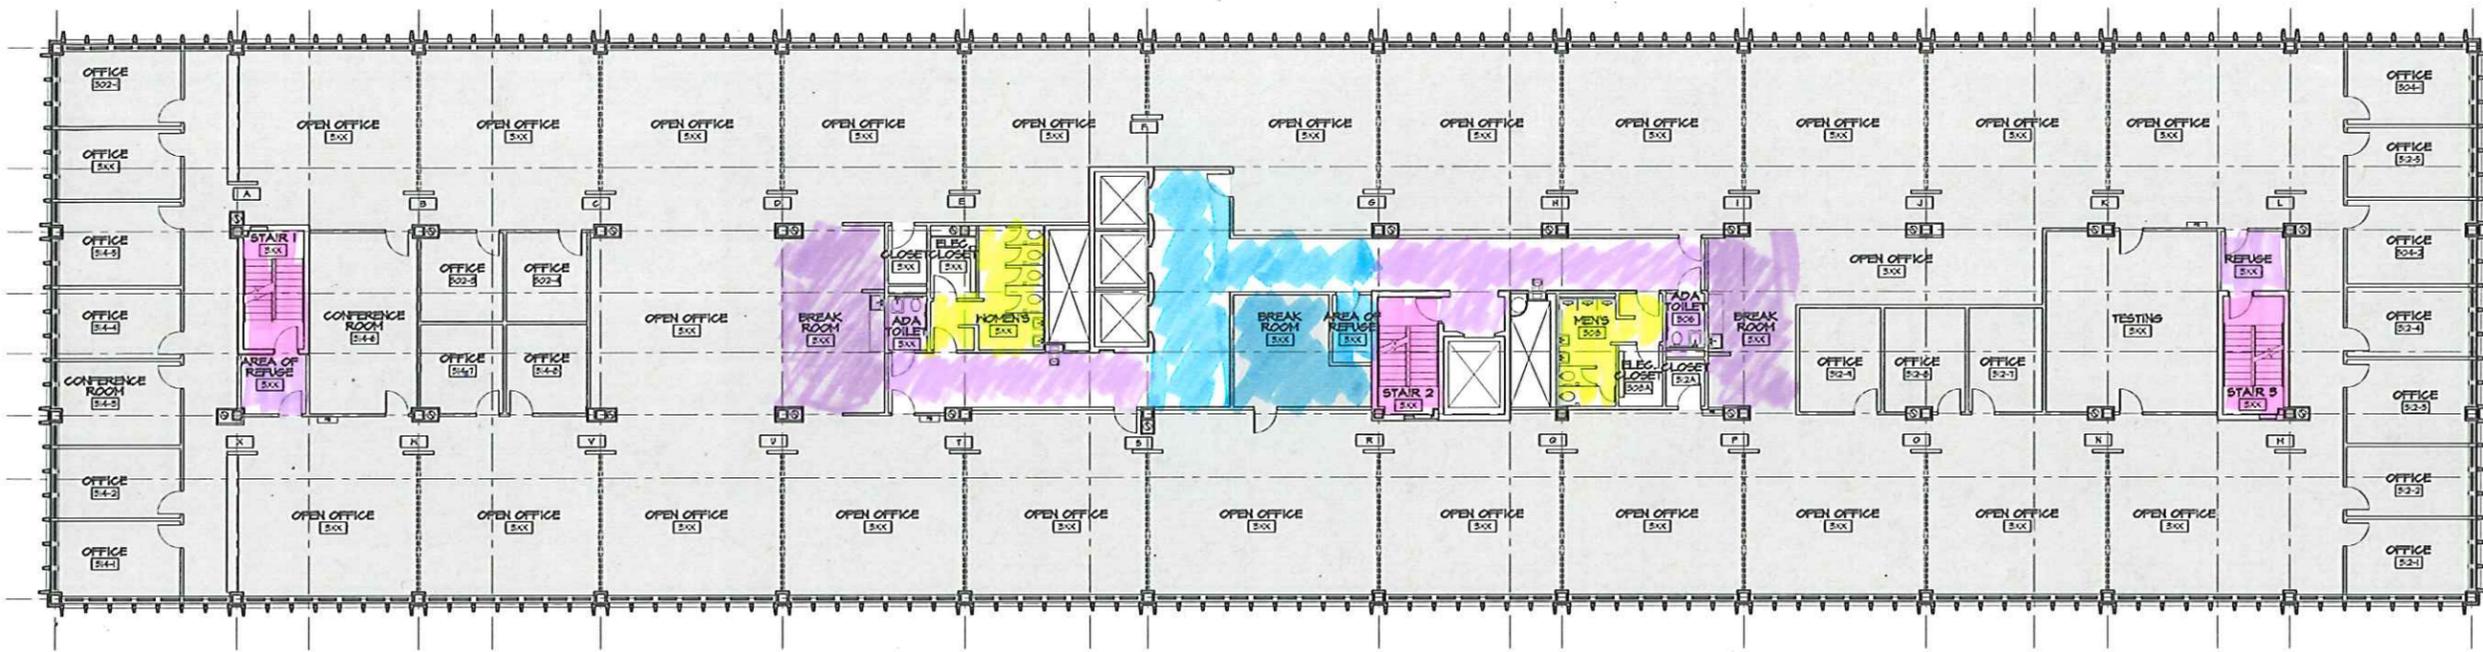


**DEPARTMENT INDEX:
3RD FLOOR**

□ OESC	20,420 sqft
□ BUILDING SUPPORT	2,910 sqft
	<hr/> 23,330 sqft

B 3rd FLOOR PLAN
SCALE: 3/32" = 1'-0"
NORTH 0 2 4 8 16 FEET

**DEPARTMENT INDEX:
2ND FLOOR**

□ OMES	15,702 sqft
□ SECRETARY OF STATE	2,988 sqft
▨ CONFERENCE ROOM	1,210 sqft
□ BUILDING SUPPORT	3,430 sqft
	<hr/> 23,330 sqft

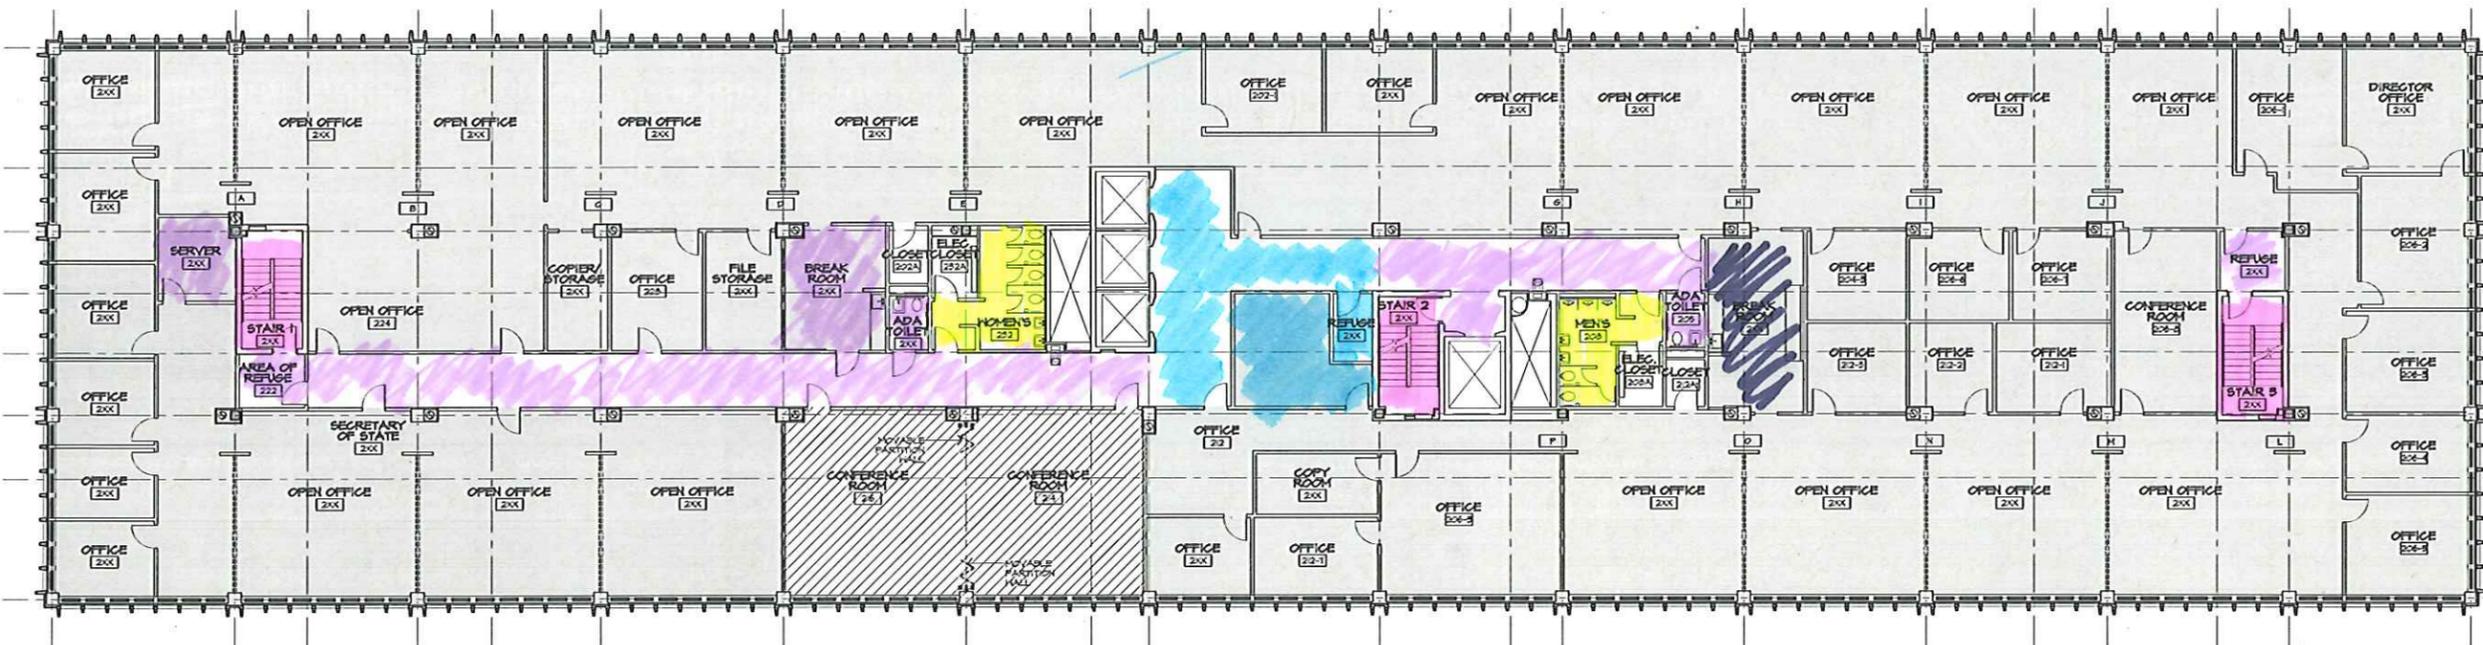

A 2nd FLOOR PLAN
SCALE: 3/32" = 1'-0"
NORTH 0 2 4 8 16 FEET

**Will Rogers
Existing Conditions
Oklahoma City, Oklahoma
Floor Plans**

GH2 ARCHITECTS

320 South Boston, Suite 1600
Tulsa, OK 74103
T: 918.587.6158 GH2.COM
A SPECIALTY PRACTICE OF GH2 ARCHITECTS, LLC

INTERIM REVIEW
ONLY

DOCUMENT INCOMPLETE.
NOT INTENDED FOR PERMIT,
BIDDING OR CONSTRUCTION

ARCHITECT: THOMAS C. SEAT
LICENSE # 4183


PROJECT #: 20120027.43

ISSUE DATES:
05/12/14 As-built Review

SHEET NUMBER:

A103

© 2015 COPYRIGHT GH2 ARCHITECTS, LLC

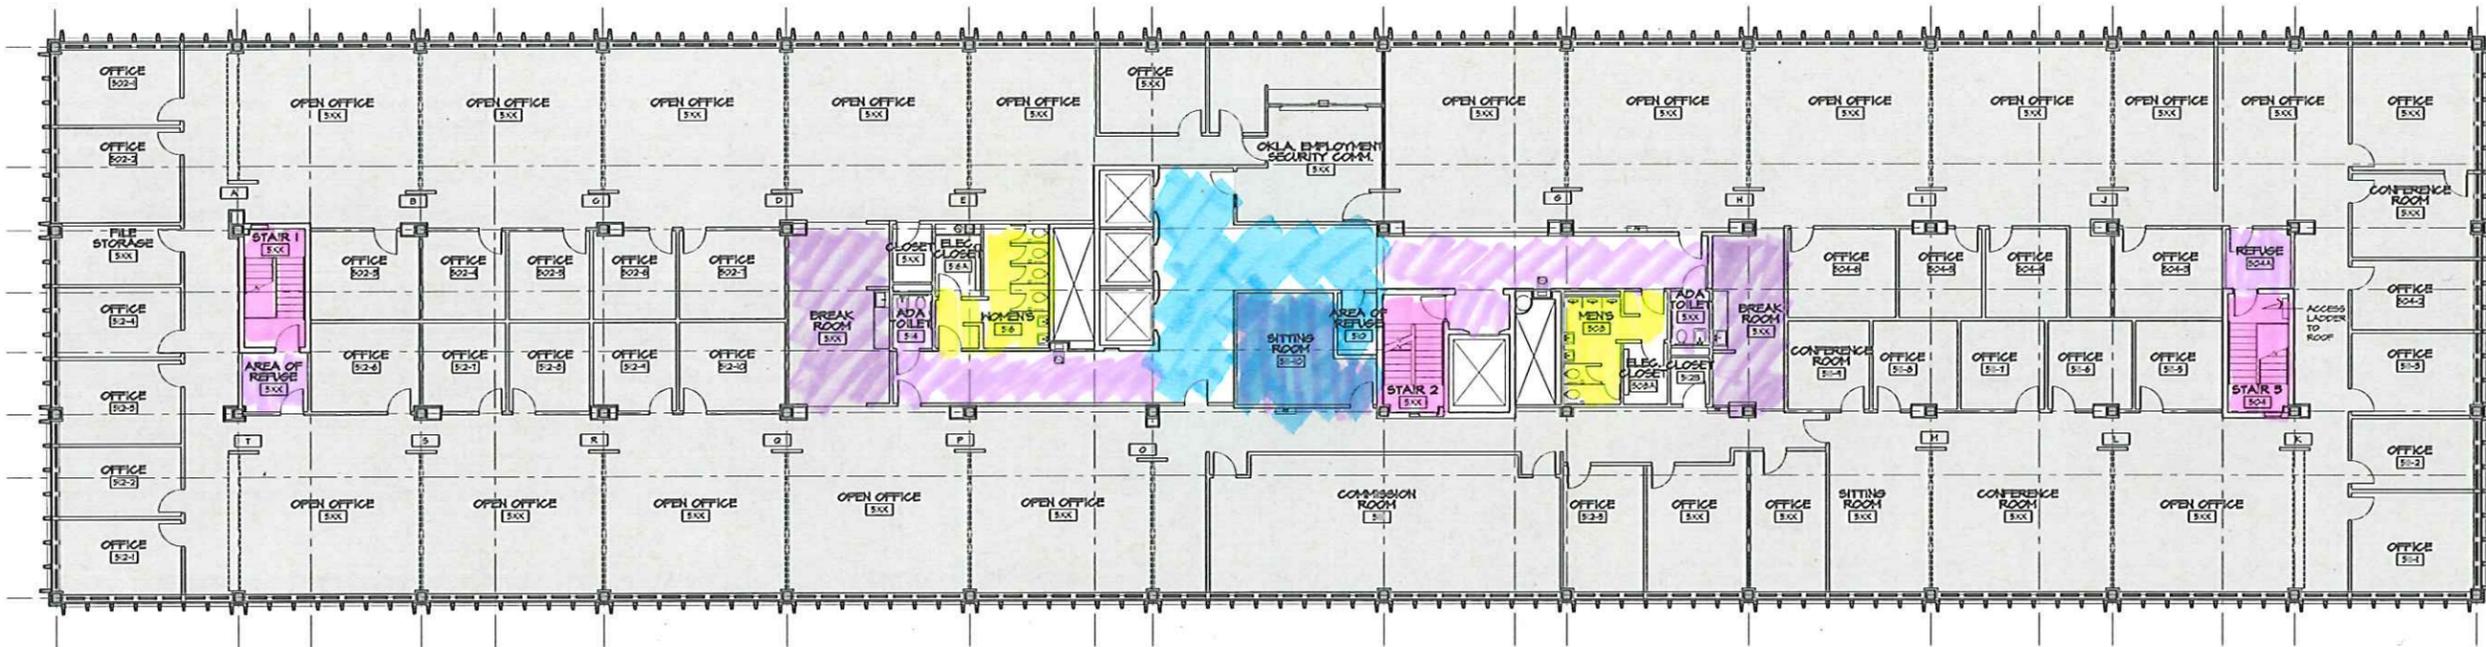


**DEPARTMENT INDEX:
5TH FLOOR**

□ OESC	20,425 sqft
□ BUILDING SUPPORT	2,905 sqft
	<hr/> 23,330 sqft

B 5th FLOOR PLAN
SCALE: 3/32" = 1'-0"
NORTH 0 2 4 8 16 FEET

**DEPARTMENT INDEX:
4TH FLOOR**

□ OESC	20,445 sqft
□ BUILDING SUPPORT	2,885 sqft
	<hr/> 23,330 sqft

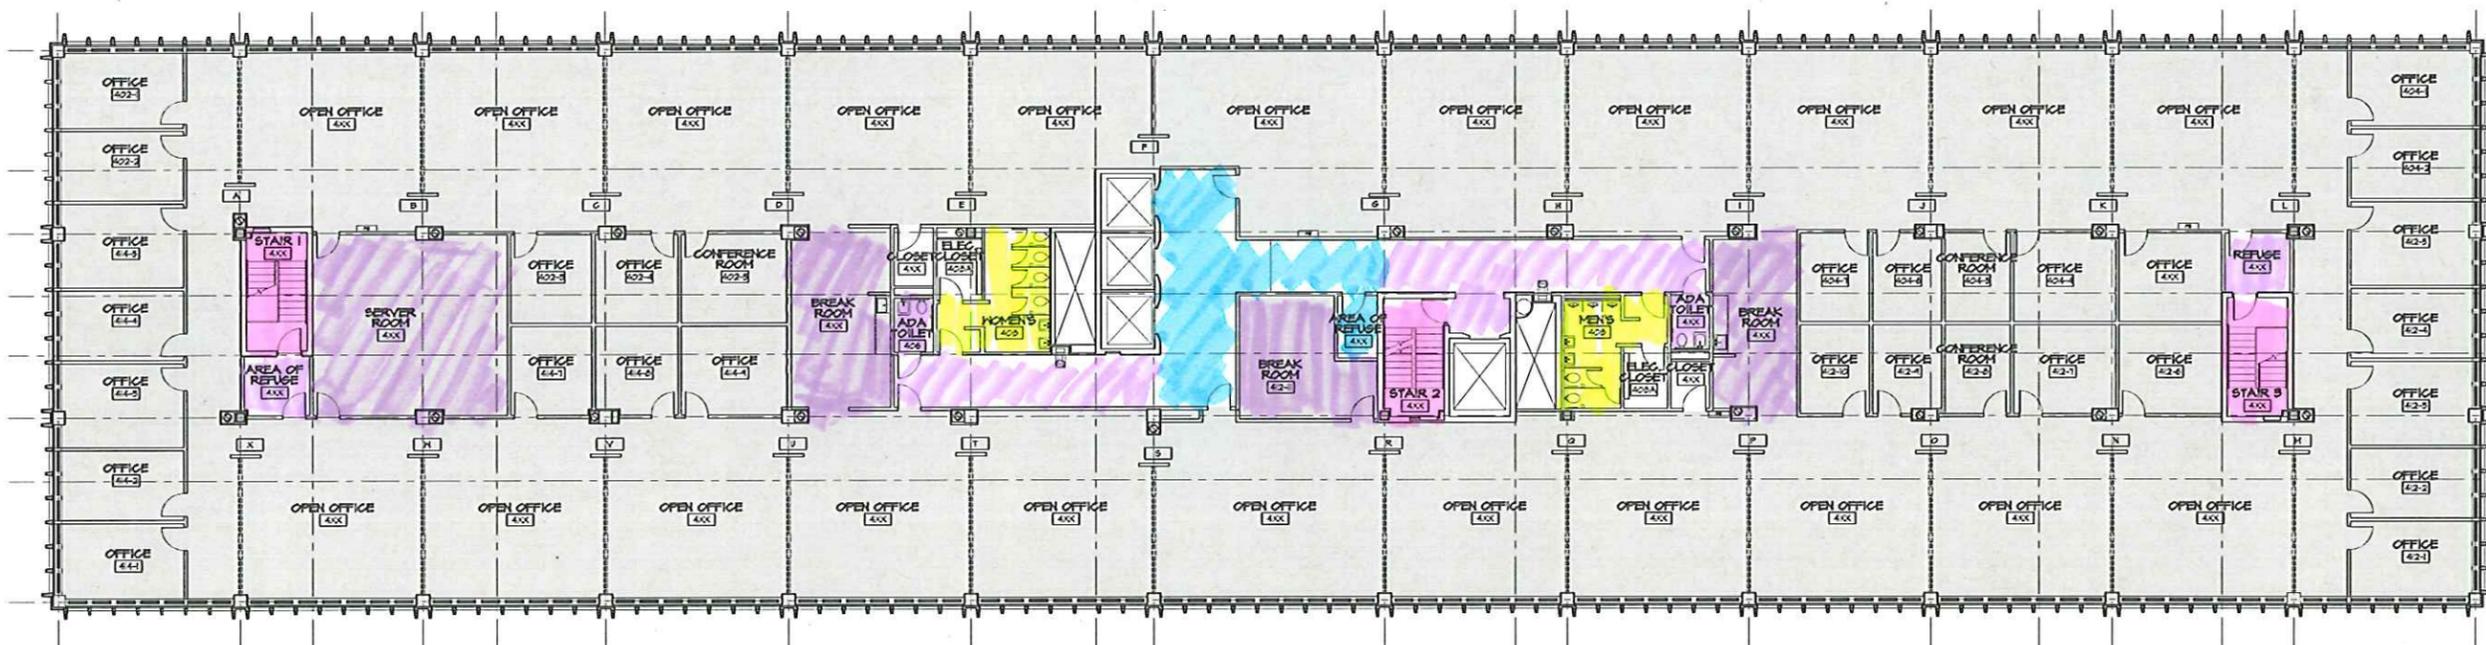

A 4th FLOOR PLAN
SCALE: 3/32" = 1'-0"
NORTH 0 2 4 8 16 FEET

**Will Rogers
Existing Conditions
Oklahoma City, Oklahoma
Floor Plans**

GH2 ARCHITECTS
320 South Boston, Suite 1600
Tulsa, OK 74103
T: 918.587.6158 GH2.COM
A SPECIALTY PRACTICE OF GH2 ARCHITECTS, LLC

**INTERIM REVIEW
ONLY**
DOCUMENT INCOMPLETE.
NOT INTENDED FOR PERMIT,
BIDDING OR CONSTRUCTION

PROJECT #: 20120027.43
ISSUE DATES:
05/12/14 As-built Review

SHEET NUMBER:
A104
© 2015 COPYRIGHT GH2 ARCHITECTS, LLC

PRINTED: 5/12/2015 10:01 AM